

STATE ENGINEER  
Salem, Oregon

Well Record JACK STATE WELL NO. 33/1-30  
18837 COUNTY JACKSON  
APPLICATION NO. GR-2471

OWNER: Millard Wilde


MAILING ADDRESS:

LOCATION OF WELL: Owner's No.

CITY AND STATE: Trail, Oregon

NW<sup>1</sup>/<sub>4</sub> SW <sup>1</sup>/<sub>4</sub> SE <sup>1</sup>/<sub>4</sub> Sec. 30 T. 33 N. S., R. 1 E. W.M.

Bearing and distance from section or subdivision corner 778' N. and 37' E.

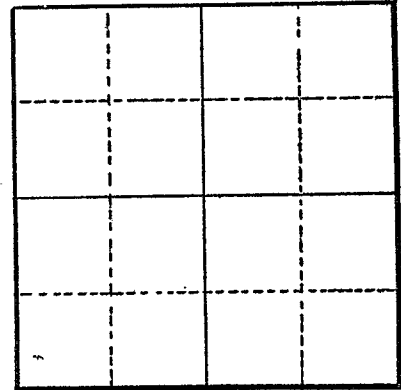

Section

Altitude at well

TYPE OF WELL: Drilled Date Constructed 1952

Depth drilled 58 Depth cased 58

CASING RECORD:

6.0-inch

FINISH:

AQUIFERS:

WATER LEVEL:

7-feet

PUMPING EQUIPMENT: Type Centrifugal pump H.P. 1

Capacity 1200 G.P.M.

WELL TESTS:

Drawdown ft. after hours G.P.M.

Drawdown ft. after hours G.P.M.

USE OF WATER Irrigation Temp. °F., 19

SOURCE OF INFORMATION GR-2340

DRILLER or DIGGER

ADDITIONAL DATA:

Log Water Level Measurements Chemical Analysis Aquifer Test

REMARKS: