

STATE ENGINEER
Salem, Oregon

Well Record **JACK** STATE WELL NO. 33/1-32F
18849 COUNTY Jackson
APPLICATION NO. GR-3061

OWNER: Mrs. Carolyn H. Kelsey MAILING ADDRESS: Cottage Kitchen

LOCATION OF WELL: Owner's No. CITY AND STATE: Trail, Oregon


SE 1/4 NW 1/4 Sec. 32 T. 33 S., R. 1 E., W.M.

Bearing and distance from section or subdivision corner 520 feet N. and 215 feet W.

Altitude at well

TYPE OF WELL: Drilled Date Constructed 1949

Depth drilled 110 feet Depth cased 110 feet

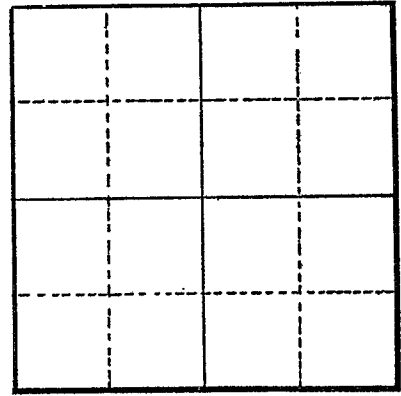

Section

CASING RECORD:
6-inch

FINISH:

AQUIFERS:

WATER LEVEL:

PUMPING EQUIPMENT: Type H.P. 2
Capacity 33 1/3 G.P.M.

WELL TESTS:
Drawdown ft. after hours G.P.M.
Drawdown ft. after hours G.P.M.

USE OF WATER In case, supplemental irrig. Temp. °F., 19

SOURCE OF INFORMATION GR-2865
DRILLER or DIGGER Diester's Well Drilling Co.

ADDITIONAL DATA:
Log Water Level Measurements Chemical Analysis Aquifer Test

REMARKS: