

STATE ENGINEER
Salem, Oregon

Jack
2005 **Well Record**


STATE WELL NO. 38/1-32K
COUNTY Jackson
APPLICATION NO. GR-3634

OWNER: Dallas S. De Lap MAILING ADDRESS: 749 Eagle Mill Road

LOCATION OF WELL: Owner's No. _____ CITY AND STATE: Ashland, Oregon

NW 1/4 SE 1/4 Sec. 32 T. 38 S., R. 1 W, W.M.

Bearing and distance from section or subdivision corner 80° S. & 570' E. from center of sec. 32

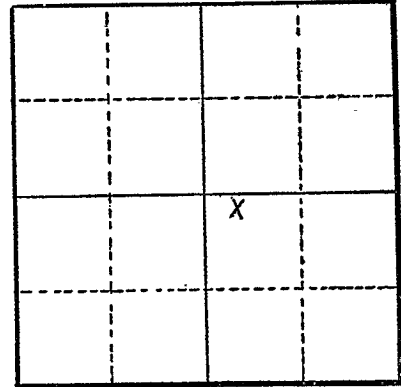

Section 32

Altitude at well _____

TYPE OF WELL: drilled Date Constructed Nov., 1952

Depth drilled 126 feet Depth cased 12 feet

CASING RECORD:

6 inch .280" casing set to 12 feet

FINISH:

AQUIFERS:

WATER LEVEL:

15 feet below surface

PUMPING EQUIPMENT: Type Reda Pump Type 54S H.P. 5
Capacity 60 G.P.M.

WELL TESTS:

Drawdown 45 ft. after _____ hours 30 G.P.M.
Drawdown 57 ft. after _____ hours 42 G.P.M.

USE OF WATER Irrigation Temp. _____ °F., 19 _____

SOURCE OF INFORMATION Well Registration Statement

DRILLER or DIGGER Dallas S. De Lap

ADDITIONAL DATA:

Log X Water Level Measurements _____ Chemical Analysis _____ Aquifer Test _____

REMARKS:

