

STATE ENGINEER
Salem, Oregon

*Jack
20917*

Well Record

STATE WELL NO. 39/2-32B(1)
COUNTY Jackson
APPLICATION NO. GR-1171

GR- 1132

OWNER: Lester R. Hazelwood


MAILING ADDRESS: 400 Greensprings Hwy.

LOCATION OF WELL: Owner's No.

CITY AND STATE: Ashland, Oregon

NW ¼ NE ¼ Sec. 32 T. 39 S., R. 2 E., W.M.

Bearing and distance from section or subdivision corner 480' S. & 2270' W. from NE cor. Sec. 32.

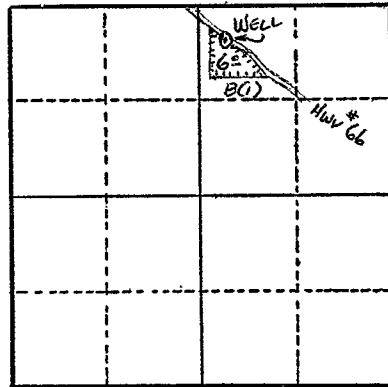

Section 32 ft.

Altitude at well 2340 ft.

TYPE OF WELL: Drilled Date Constructed 1951

Depth drilled 101.5 ft. Depth cased 11 ft.

CASING RECORD:

6 in. from 0 to 11 ft.

FINISH:

AQUIFERS:

WATER LEVEL:

40 ft.

PUMPING EQUIPMENT: Type 3 in. Cent. H.P. 65

Capacity G.P.M.

WELL TESTS:

Drawdown 5 ft. after 1100 hours G.P.M.

Drawdown ft. after hours G.P.M.

USE OF WATER Irrigation Temp. °F. 19

SOURCE OF INFORMATION G. R. Record

DRILLER or DIGGER Dallas S. Delap

ADDITIONAL DATA:

Log N. A. Water Level Measurements Chemical Analysis Aquifer Test

REMARKS:

Irrigation of 6 acres.