

STATE ENGINEER
Salem, Oregon

JACK
34825

Well Record

STATE WELL NO. 37/2W-10E(1)
COUNTY Jackson
APPLICATION NO. GR-381

OWNER: David Blumenstein


MAILING ADDRESS: Route 1, Box 210

LOCATION OF WELL: Owner's No.

CITY AND STATE: Central Point, Oregon

SW 1/4 NW 1/4 Sec. 10 T. 37 N. R. 2 E. W.M.

Bearing and distance from section or subdivision corner 1040' N. & 340' E. from W 1/4 cor. Sec. 10

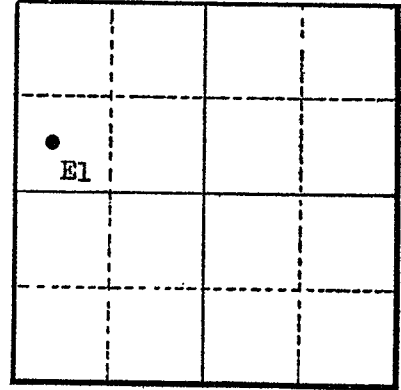

Altitude at well 1390'

TYPE OF WELL: Dug Date Constructed Aug '50

Depth drilled 18 Depth cased

Section 10

CASING RECORD:

FINISH:

AQUIFERS:

WATER LEVEL:

PUMPING EQUIPMENT: Type Centrifugal 2" H.P. 3
Capacity 60 G.P.M.

WELL TESTS:

Drawdown ft. after hours G.P.M.
Drawdown ft. after hours G.P.M.

USE OF WATER Irrigation 4 acres Temp. °F., 19

SOURCE OF INFORMATION

DRILLER or DIGGER

ADDITIONAL DATA:

Log No Water Level Measurements Chemical Analysis Aquifer Test

REMARKS:

Sump: 150' long, 12' wide, 0 to 18' deep