

STATE ENGINEER  
Salem, Oregon

# Well Record

STATE WELL NO. 37/2W-100  
COUNTY Jackson  
APPLICATION NO. GR-3649

*JACK*  
*34826*

OWNER: Fred R. Kuest


MAILING ADDRESS: 1910 Beall Lane

LOCATION OF WELL: Owner's No.

CITY AND STATE: Medford, Oregon

SW 1/4 SE 1/4 Sec. 10 T. 37 S., R. 2 W., W.M.

Bearing and distance from section or subdivision  
corner 288' N. & 1652' E. from NW cor. of DLC #66

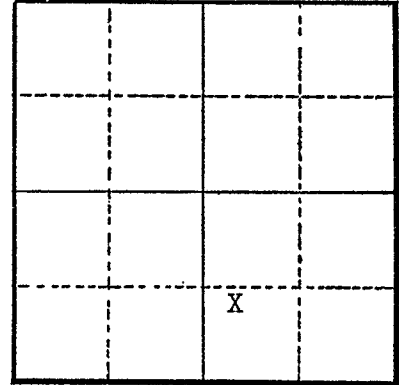

Section 10

Altitude at well

TYPE OF WELL: Dug Date Constructed 1947

Depth drilled 18 feet Depth cased 18 feet

### CASING RECORD:

Sump is concrete line on sides from 0 to 18 feet

### FINISH:

### AQUIFERS:

### WATER LEVEL:

6.0 feet below surface

PUMPING EQUIPMENT: Type Fairbanks Morse centrifugal H.P. 7.5  
Capacity G.P.M.

### WELL TESTS:

Drawdown 6.0 ft. after 250 hours G.P.M.

Drawdown ft. after hours G.P.M.

USE OF WATER Irrigation Temp. °F., 19

SOURCE OF INFORMATION Well Registration Statement

DRILLER or DIGGER

### ADDITIONAL DATA:

Log  Water Level Measurements  Chemical Analysis  Aquifer Test

### REMARKS:

Log:

Black top soil  
Sandy loam  
Granite and gravel (water bearing)

Thickness	Depth to Bottom
6	12
4	8
8	0