

STATE ENGINEER  
Salem, Oregon

JACK  
34827

# Well Record

STATE WELL NO. 37/2W-10R...  
COUNTY Jackson...  
APPLICATION NO. GR-1704...

GR- 1653

OWNER: Thurman Barnes


MAILING ADDRESS: 1576 Beall Lane

LOCATION OF WELL: Owner's No.

CITY AND STATE: Medford, Oregon

SE 1/4 SE 1/4 Sec. 10 T. 37 S., R. 2 W., W.M.

Bearing and distance from section or subdivision corner 230' N. & 3565' W. from SE cor. DLC #54.

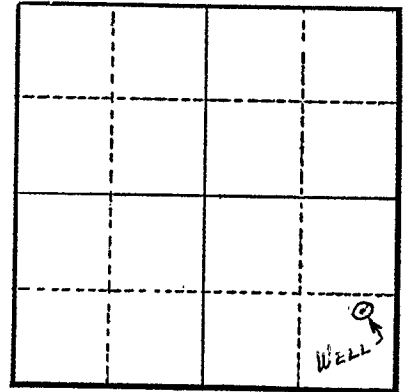

Section 10

Altitude at well 1295'

TYPE OF WELL: Dug Date Constructed 1951

Depth drilled 26' Depth cased 8'

### CASING RECORD:

96" concrete building blocks from 0 to 8 ft.

### FINISH:

### AQUIFERS:

### WATER LEVEL:

7'

PUMPING EQUIPMENT: Type Weinman 1 1/2" x 1 1/4" Cent. H.P. 2  
Capacity 40 G.P.M.

### WELL TESTS:

Drawdown 19 ft. after 4 hours 25 G.P.M.

Drawdown ft. after hours G.P.M.

USE OF WATER Irrigation Temp. °F., 19

SOURCE OF INFORMATION GR Record

DRILLER or DIGGER Claimant

### ADDITIONAL DATA:

Log N.A. Water Level Measurements Chemical Analysis Aquifer Test

### REMARKS:

Irrigation of 3 acres.