

STATE ENGINEER  
Salem, Oregon

JACK  
34858

# Well Record

STATE WELL NO. 37/2W-11G  
COUNTY Jackson  
APPLICATION NO. GR-3079

OWNER: C. F. McKibben


MAILING ADDRESS: 833 Hopkins Road

LOCATION OF WELL: Owner's No.

CITY AND STATE: Central Point, Oregon

SW 1/4 NE 1/4 Sec. 11 T. 37 N. S. R. 2 E. W., W.M.

Bearing and distance from section or subdivision corner 189 ft. S. and 222 ft. W. from the NW cor. of Lot 18.

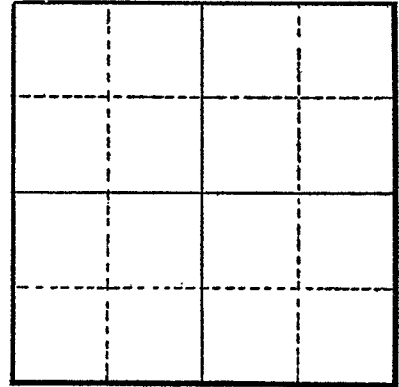

Section .....

Altitude at well .....

TYPE OF WELL: Drilled Date Constructed 1953

Depth drilled 116 feet Depth cased 116 feet

### CASING RECORD:

6-inch

### FINISH:

24 perforations 1" x 2" in the 58 feet of casing

### AQUIFERS:

### WATER LEVEL:

30 feet

PUMPING EQUIPMENT: Type 1 1/4" centrifugal pump (Jet) Gordon H.P. 1.0  
Capacity G.P.M.

### WELL TESTS:

Drawdown ..... ft. after ..... hours ..... G.P.M.  
Drawdown ..... ft. after ..... hours ..... G.P.M.

USE OF WATER Irrigation Temp. °F., 19.

SOURCE OF INFORMATION GR-2885

DRILLER or DIGGER Shults Brothers

### ADDITIONAL DATA:

Log ..... Water Level Measurements ..... Chemical Analysis ..... Aquifer Test .....

### REMARKS: