

STATE ENGINEER
Salem, Oregon

34860
JACK

Well Record

STATE WELL NO. 37/2W-11G
COUNTY JACKSON
APPLICATION NO. GR-2979

OWNER: Kenneth Gosbel


MAILING ADDRESS: 882 Hopkins Road

LOCATION OF WELL: Owner's No.

CITY AND STATE: Central Point, Oregon

SW 1/4 NE 1/4 Sec. 11 T. 37 ^{N.} S, R. 2 ^{E.} W., W.M.

Bearing and distance from section or subdivision corner 1800' W. and 1600' S.

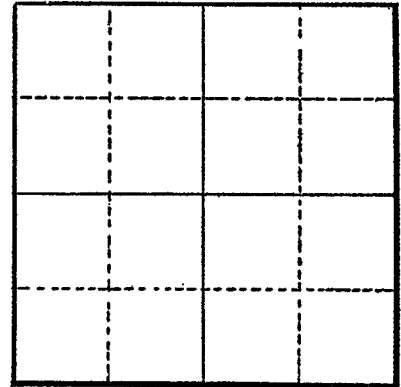

Section

Altitude at well

TYPE OF WELL: dug Date Constructed 1927

Depth drilled Depth cased

CASING RECORD:

FINISH:

AQUIFERS:

WATER LEVEL:

PUMPING EQUIPMENT: Type Centrifugal pump H.P. 1/4
Capacity 12 G.P.M.

WELL TESTS:

Drawdown ft. after hours G.P.M.
Drawdown ft. after hours G.P.M.

USE OF WATER irrigation Temp. °F., 19

SOURCE OF INFORMATION GR-2790

DRILLER or DIGGER

ADDITIONAL DATA:

Log Water Level Measurements Chemical Analysis Aquifer Test

REMARKS: