

STATE ENGINEER
Salem, Oregon

34862
JACK

Well Record


STATE WELL NO. 37/2W-11K
COUNTY Jackson
APPLICATION NO. GR-3652

OWNER: William H. Straus
MAILING ADDRESS: 3392 Bursell Rd.

LOCATION OF WELL: Owner's No. _____
CITY AND STATE: Medford, Oregon

NW 1/4 SE 1/4 Sec. 11 T. 37 S., R. 2 W., W.M.

Bearing and distance from section or subdivision
corner 1410' W & 720' S from E 1/4 cor Sec 11

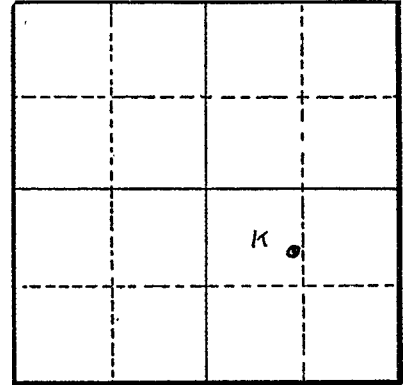

Section 11

Altitude at well _____

TYPE OF WELL: Dug Date Constructed 1955

Depth drilled 20' Depth cased not cased

CASING RECORD:

FINISH:

AQUIFERS:

WATER LEVEL: 15'

PUMPING EQUIPMENT: Type Stout H.P. 2
Capacity 45 G.P.M.

WELL TESTS:
Drawdown _____ ft. after _____ hours _____ G.P.M.
Drawdown _____ ft. after _____ hours _____ G.P.M.

USE OF WATER Irrigation Temp. _____ °F., 19

SOURCE OF INFORMATION GR-3921

DRILLER or DIGGER Trumix

ADDITIONAL DATA:
Log NA Water Level Measurements _____ Chemical Analysis _____ Aquifer Test _____

REMARKS: