

STATE ENGINEER
Salem, Oregon

31864
JACK

Well Record


STATE WELL NO. 37/2W-11Q
COUNTY Jackson
APPLICATION NO. GR-4221

OWNER: Eldred F. Charley MAILING ADDRESS: 744 Beall Lane

LOCATION OF WELL: Owner's No. CITY AND STATE: Medford, Oregon

SW 1/4 SE 1/4 Sec. 11 T. 37 S., R. 2 W., W.M.

Bearing and distance from section or subdivision corner 250' N. & 695' E. from SW Cor. DIC 58

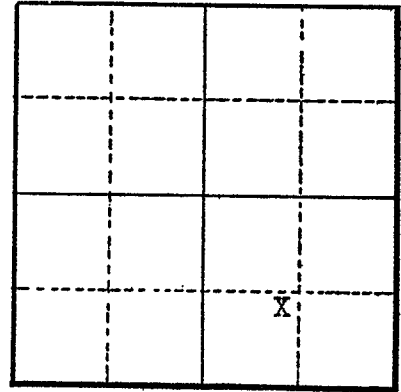

Section 11

Altitude at well

TYPE OF WELL: Dug Date Constructed 1938

Depth drilled 20 ft. Depth cased 20 ft.

CASING RECORD:

6' x 6' concrete casing set to 8 feet
6' x 6' redwood planking from 8 to 20 feet

FINISH:

AQUIFERS:

WATER LEVEL:

6.0 feet below surface

PUMPING EQUIPMENT: Type 1.0" centrifugal pump H.P. 3
Capacity 60 G.P.M.

WELL TESTS:

Drawdown 14 ft. after 60 hours G.P.M.
Drawdown ft. after hours G.P.M.

USE OF WATER Irrigation Temp. °F. 19

SOURCE OF INFORMATION Well Registration Statement Cert. # GR-3764

DRILLER or DIGGER Joe Johnson

ADDITIONAL DATA:

Log Water Level Measurements Chemical Analysis Aquifer Test

REMARKS: