

STATE ENGINEER  
Salem, Oregon

*SACK*  
*34868*

# Well Record


STATE WELL NO. 37/2W-12  
COUNTY JACKSON  
~~APPLICATION NO.~~ GR-2987

OWNER: Chapman and Hart by Walter L. and Marjorie E. Chapman MAILING ADDRESS: 3362 Table Rock Road

LOCATION OF WELL: Owner's No. \_\_\_\_\_ CITY AND STATE: Medford, Oregon

NW<sup>1</sup>/<sub>4</sub> NW <sup>1</sup>/<sub>4</sub> SE <sup>1</sup>/<sub>4</sub> Sec. 12 T. 37 S., R. 2 W., W.M.

Bearing and distance from section or subdivision corner 245' N. and 194' W. from the East SE corner of DLC #58.

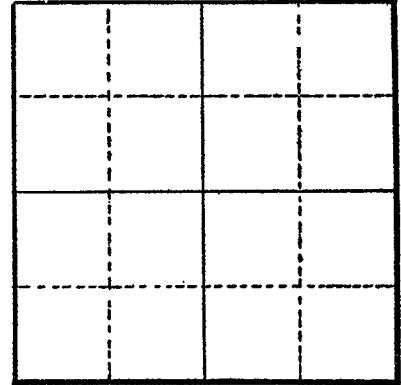

Section .....

Altitude at well .....

TYPE OF WELL: dug Date Constructed 1952

Depth drilled 18.5 Depth cased .....

### CASING RECORD:

### FINISH:

### AQUIFERS:

### WATER LEVEL:

9.0-feet

PUMPING EQUIPMENT: Type Centrifugal pump H.P. 2.0  
Capacity 50 G.P.M.

WELL TESTS:  
Drawdown 9 ft. after \_\_\_\_\_ hours Pumping 50 in 4 hours G.P.M.  
Drawdown \_\_\_\_\_ ft. after \_\_\_\_\_ hours \_\_\_\_\_ G.P.M.

USE OF WATER irrigation Temp. \_\_\_\_\_ °F., 19.....

SOURCE OF INFORMATION GR-2782

DRILLER or DIGGER .....

### ADDITIONAL DATA:

Log \_\_\_\_\_ Water Level Measurements \_\_\_\_\_ Chemical Analysis \_\_\_\_\_ Aquifer Test \_\_\_\_\_

### REMARKS: