

STATE ENGINEER  
Salem, Oregon

JACK  
34875

# Well Record


STATE WELL NO. 37/2W-13B(1)  
COUNTY Jackson  
APPLICATION NO. GR-456

OWNER: J. D. Hight MAILING ADDRESS: 2810 Table Rock Road

LOCATION OF WELL: Owner's No. CITY AND STATE: Medford, Oregon

NW 1/4 NE 1/4 Sec. 13 T. 37 N. S., R. 2 W., W.M.

Bearing and distance from section or subdivision corner 1041' S. & 180' E. from NW cor. Sec. 13

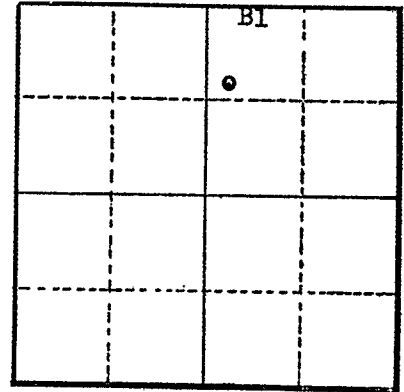

Altitude at well 1280

TYPE OF WELL: Dug Date Constructed May '47

Depth drilled 10 Depth cased

Section 13

### CASING RECORD:

5 1/2 x 5 1/2' Redwood cased to 7'  
" " concrete 7 to 10'

FINISH:

AQUIFERS:

WATER LEVEL:

4

PUMPING EQUIPMENT: Type centrifugal H.P. 1  
Capacity 20 G.P.M.

WELL TESTS:

Drawdown ft. after hours G.P.M.  
Drawdown ft. after hours G.P.M.

USE OF WATER Irrigation 1 acre Temp. °F. 19

SOURCE OF INFORMATION GR-456

DRILLER or DIGGER

ADDITIONAL DATA:

Log No Water Level Measurements Chemical Analysis Aquifer Test

REMARKS: