

STATE ENGINEER
Salem, Oregon

JACK
34876

Well Record

STATE WELL NO. 37/2W-13C
COUNTY Jackson
APPLICATION NO. GR-1636

GR- 1601

OWNER: James F. & Hazel M. Myers


MAILING ADDRESS: 2829 Table Rock Rd.

LOCATION OF WELL: Owner's No.

CITY AND STATE: Medford, Oregon

NE 1/4 NW 1/4 Sec. 13 T. 37 S. R. 2 W., W.M.

Bearing and distance from section or subdivision corner 1810' N. & 1905' E. from SW cor. DIC #59

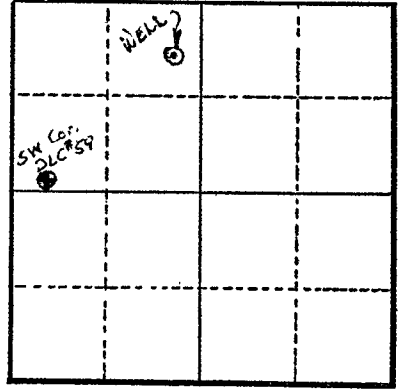

Section 13

Altitude at well 1295'

TYPE OF WELL: Dug Date Constructed 1955

Depth drilled 13' Depth cased 13'

CASING RECORD:

- 8" concrete tile from 0 to 7 ft.
- 30" concrete tile from 7 to 13 ft.

FINISH:

1" perforations in 30" tile about 8 per ft. from 7 to 13 ft.

AQUIFERS:

Gravel

WATER LEVEL:

4'

PUMPING EQUIPMENT: Type Berkeley 1 1/4" x 1" Cent. H.P. 2

Capacity 55 G.P.M.

WELL TESTS:

Drawdown ft. after hours G.P.M.

Drawdown ft. after hours G.P.M.

USE OF WATER Irrigation Temp. °F. 19

SOURCE OF INFORMATION GR Record

DRILLER or DIGGER M. C. Lininger & Son

ADDITIONAL DATA:

Log Water Level Measurements Chemical Analysis Aquifer Test

REMARKS:

- Log: Black top soil 0 to 2 ft.
- Fine sand 2 to 7 ft.
- Gravel (water) medium 7 to 13 ft.

Irrigatio of 2.85 acres.