

STATE ENGINEER
Salem, Oregon

JACK
34877

Well Record


STATE WELL NO. 37/2W-13G
COUNTY Jackson
APPLICATION NO. GR-3541

OWNER: Malcolm McCarty and Besie McCarty MAILING ADDRESS: 2618 Table Rock Road

LOCATION OF WELL: Owner's No. CITY AND STATE: Medford, Oregon

NW 1/4 SE 1/4 Sec. 13 T. 37 S., R. 2 W., W.M.

Bearing and distance from section or subdivision
corner 371.7 ft. West and 760 ft. North of the
Southeast corner of donation land claim #38
in T. 37 S., R. 1 W., of the W.M.

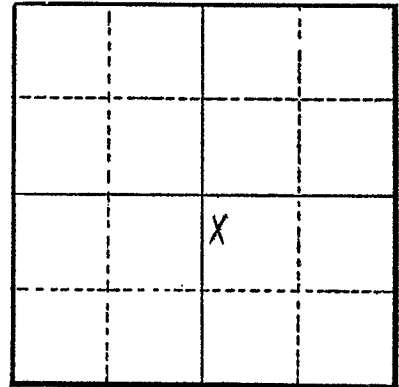

Section 13

Altitude at well

TYPE OF WELL: Dug Date Constructed 1943

Depth drilled 16 ft. Depth cased 16 ft.

CASING RECORD:

72 inch casing set to 16 ft.

FINISH:

AQUIFERS:

WATER LEVEL:

8 feet below surface

PUMPING EQUIPMENT: Type Berkeley General Electric H.P. 3
Capacity 60 G.P.M.

WELL TESTS:

Drawdown 2 ft. after 40 hours G.P.M.
Drawdown 2 ft. after 60 hours G.P.M.

USE OF WATER Irrigation Temp. °F., 19

SOURCE OF INFORMATION Well Registration Statement

DRILLER or DIGGER

ADDITIONAL DATA:

Log Water Level Measurements Chemical Analysis Aquifer Test

REMARKS: