

STATE ENGINEER
Salem, Oregon

SACK JACK 34879
Well Record

STATE WELL NO. 37/2W-14L
COUNTY Jackson
APPLICATION NO. GR-1238

GR- 1319

OWNER: George C. Flanagan


MAILING ADDRESS: Box 606

LOCATION OF WELL: Owner's No.

CITY AND STATE: Medford, Oregon

NE 1/4 SW 1/4 Sec. 14 T. 37 S., R. 2 W., W.M.

Bearing and distance from section or subdivision corner 3683.3' N55°26'W. from SE cor. Sec. 14.

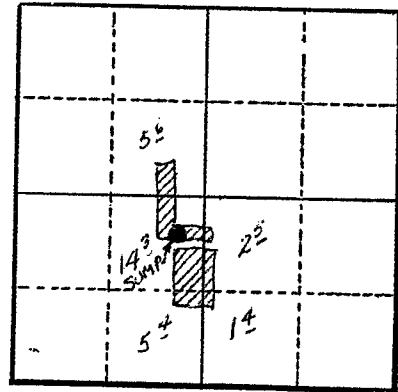

Section 14

Altitude at well 1315 ft.

TYPE OF WELL: Dug Date Constructed 1955

Depth drilled 16 ft. Depth cased Sump

CASING RECORD:

Infiltration trench: 450' x 4' x 16'

FINISH:

AQUIFERS:

WATER LEVEL:

5 ft.

PUMPING EQUIPMENT: Type Pump, Pipe & Power 5 in. Cent. H.P. 3
Capacity 215 G.P.M.

WELL TESTS:

Drawdown 5.5 ft. after 190 hours G.P.M.
Drawdown 0.25 ft. after 70 hours G.P.M.

USE OF WATER Indust. & Irrigation Temp. °F. 19

SOURCE OF INFORMATION G. R. Record

DRILLER or DIGGER

ADDITIONAL DATA:

Log N.A. Water Level Measurements Chemical Analysis Aquifer Test

REMARKS:

Irrigation of 29.2 acres.

NOV - 4 1996

WELL IDENTIFICATION FORM

WATER RESOURCES DEPT.
SALEM, OREGON

CURRENT WELL OWNER:

Owner's Well Number: _____

Name: George C. Flanagan

Mailing Address: 220 Laurel St

City: Medford State: OR. Zip: 97501

If a well report is available for this well, please attach a copy of it to this form and return. It is not necessary for you to complete the remainder of the form if the well report is attached. If a well report is not available, please complete the remainder of the form to the best of your ability.

WELL LOCATION:

County: Jackson Latitude: JACK 34879 Longitude: _____

Township: 37 N or S Range: 2W E or W Section: 14 _____ 1/4 _____ 1/4

Tax Lot Number: multiple tax lots

Street Address of Well (if different than above): 1548 Ross Lane
Medford, Oregon

WELL INFORMATION:

Start Card Number: _____ Approx. Construction Date: _____

Well Constructor: _____

Name of Owner at Time of Construction: _____

Well Depth (in feet): _____ Static Water Level (in feet): _____

Diameter of Exposed Well Casing (in inches): _____

Does this well have a formal water right associated with it? Yes: _____ No: _____ If yes:

Application #: _____ Permit #: _____ Certificate # _____

Please Return Completed Form to: Oregon Water Resources Department
158 12th Street NE
Salem, OR 97310

(Office use only)

Well Identification Number 12223