

STATE ENGINEER  
Salem, Oregon

*JACK* Well Record  
*34909*

STATE WELL NO. *37/2W-1*  
COUNTY *Jackson*  
APPLICATION NO. *GR-2690*

OWNER: *Lamar Dodd*


MAILING ADDRESS: *137 West Vilas Road*

LOCATION OF WELL: Owner's No. \_\_\_\_\_

CITY AND STATE: *Central Point, Oregon*

*NW*<sup>1</sup>/<sub>4</sub> *NE*<sup>1</sup>/<sub>4</sub> *NW*<sup>1</sup>/<sub>4</sub> Sec. *1* T. *37* S., R. *2* W., W.M.

Bearing and distance from section or subdivision  
corner *295 ft. S. and 774' W.*

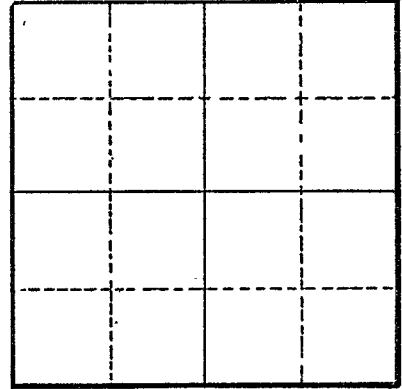

Altitude at well \_\_\_\_\_

TYPE OF WELL: *Dug* Date Constructed *1938*

Depth drilled *40'* Depth cased \_\_\_\_\_

Section \_\_\_\_\_

CASING RECORD:

FINISH:

AQUIFERS:

WATER LEVEL:

*25 feet*

PUMPING EQUIPMENT: Type *Centrifugal (deep well)* H.P. *2*  
Capacity *40* G.P.M.

WELL TESTS:

Drawdown \_\_\_\_\_ ft. after \_\_\_\_\_ hours \_\_\_\_\_ G.P.M.  
Drawdown \_\_\_\_\_ ft. after \_\_\_\_\_ hours \_\_\_\_\_ G.P.M.

USE OF WATER *irrigation* Temp. \_\_\_\_\_ °F. \_\_\_\_\_, 19\_\_\_\_\_

SOURCE OF INFORMATION *GR-2548*

DRILLER or DIGGER \_\_\_\_\_

ADDITIONAL DATA:

Log \_\_\_\_\_ Water Level Measurements \_\_\_\_\_ Chemical Analysis \_\_\_\_\_ Aquifer Test \_\_\_\_\_

REMARKS: