

STATE ENGINEER
Salem, Oregon


JACK
34910
Well Record

STATE WELL NO. 37/2W-1A
COUNTY Jackson
APPLICATION NO. GR-4037

OWNER: G. F. Brood
MAILING ADDRESS: 4922 Gebhard Rd.
CITY AND STATE: Central Point, Oregon

LOCATION OF WELL: Owner's No. _____
NE 1/4 NE 1/4 Sec. 1 T. 37 S., R. 2 W., W.M.

Bearing and distance from section or subdivision
corner 33 rods W. from NE Cor. of Sec. 1 & 2
about 10 rods N.

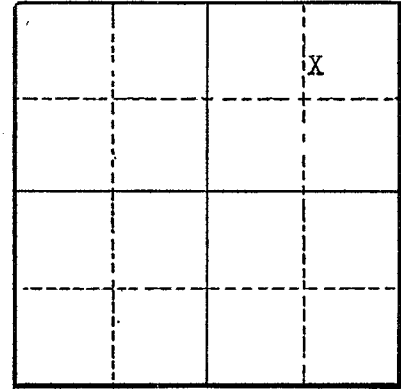

Altitude at well _____

TYPE OF WELL: Dug Date Constructed 1946
Depth drilled 20 ft. Depth cased 20 ft.

Section 1

CASING RECORD:

6 ft. diameter on top is cement blocks, then plastered for a ways then a metal casing on bottom

FINISH:

AQUIFERS:

WATER LEVEL:

14 feet below surface

PUMPING EQUIPMENT: Type 1 1/2" intake 1 1/4" outlet H.P. 3
Capacity 50 G.P.M.

WELL TESTS:

Drawdown _____ ft. after _____ hours _____ G.P.M.
Drawdown _____ ft. after _____ hours _____ G.P.M.

USE OF WATER Irrigation _____ Temp. _____ °F. _____, 19 _____

SOURCE OF INFORMATION Well Registration Statement Cert. # GR-3639

DRILLER or DIGGER _____

ADDITIONAL DATA:

Log Water Level Measurements _____ Chemical Analysis _____ Aquifer Test _____

REMARKS:

Log
yellow Thickness 10 Depth to Bottom 10
Gravel (water bearing) Thickness 10 Depth to Bottom 0