

STATE ENGINEER
Salem, Oregon

JACK
34911

Well Record

STATE WELL NO. 37/2W - 10
COUNTY JACKSON
APPLICATION NO. GR-2058

OWNER: Donald R. and Lu Ella Gardner

MAILING ADDRESS:

4775 Table Rock Road


LOCATION OF WELL: Owner's No. _____

CITY AND STATE:

Medford, Oregon

NE $\frac{1}{4}$ NW $\frac{1}{4}$ Sec. 1 T. 37 $\frac{N}{S}$, R. 2 $\frac{W}{E}$, W.M.

Bearing and distance from section or subdivision corner 1130' S. and 135' W.

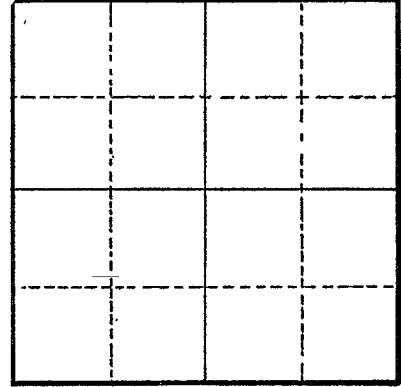

Section _____

Altitude at well _____

TYPE OF WELL: Drilled Date Constructed 1951

Depth drilled 43 Depth cased 38

CASING RECORD:

6.0-inch

FINISH:

AQUIFERS:

WATER LEVEL:

17-feet

PUMPING EQUIPMENT: Type Submersible pump

H.P. $\frac{1}{2}$

Capacity 30 G.P.M.

WELL TESTS:

Drawdown 10 ft. after _____ hours Pumping 15 G.P.M.

Drawdown _____ ft. after _____ hours _____ G.P.M.

USE OF WATER Manufacturing & Industrial Temp. _____ °F. _____, 19____

SOURCE OF INFORMATION GR-1983

DRILLER or DIGGER _____

ADDITIONAL DATA:

Log _____ Water Level Measurements _____ Chemical Analysis _____ Aquifer Test _____

REMARKS: