

STATE ENGINEER
Salem, Oregon

Well Record

STATE WELL NO. 37/2W-1L
COUNTY Jackson
APPLICATION NO. GR-1557

JACK
34912

GR- 1501

OWNER: Albert H. Puhl


MAILING ADDRESS: 4279 Table Rock Rd.

LOCATION OF WELL: Owner's No.

CITY AND STATE: Medford, Oregon

NE 1/4 SW 1/4 Sec. 1 T. 37 S., R. 2 W., W.M.

Bearing and distance from section or subdivision corner 290' S. & 96' E. from NW cor. DIC #57

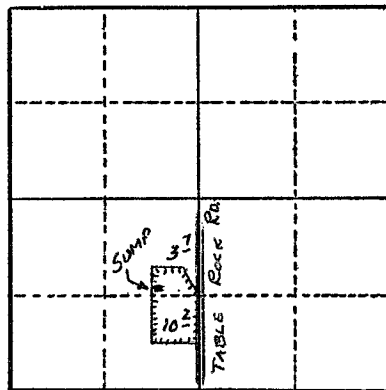

Section 1

Altitude at well 1270'

TYPE OF WELL: Dug Date Constructed 1950

Depth drilled 25' Depth cased Sump

CASING RECORD:

Infiltration trench: 16' x 28' x 25'

FINISH:

AQUIFERS:

WATER LEVEL:

7'

PUMPING EQUIPMENT: Type F. M. 2" Cent. H.P. 5
Capacity 160 G.P.M.

WELL TESTS:

Drawdown 23 ft. after hours 160 G.P.M.

Drawdown ft. after hours G.P.M.

USE OF WATER Irrigation Temp. °F., 19

SOURCE OF INFORMATION GR Record

DRILLER or DIGGER Owner

ADDITIONAL DATA:

Log N.A. Water Level Measurements Chemical Analysis Aquifer Test

REMARKS:

Irrigation of 13.9 acres.