

STATE ENGINEER
Salem, Oregon

JACK
34914
Well Record

STATE WELL NO. 37/2W-1E(1)
COUNTY Jackson
APPLICATION NO. GR-534

OWNER: Edwin Gebhard

MAILING
ADDRESS:

LOCATION OF WELL: Owner's No.


CITY AND
STATE:

Central Point, Oregon

SW 1/4 NW 1/4 Sec. 1 T. 37 N. S. R. 2 W., W.M.

Bearing and distance from section or subdivision

corner 1920' S. of N. line Sec. 1, 75' E. of
W line Sec. 1

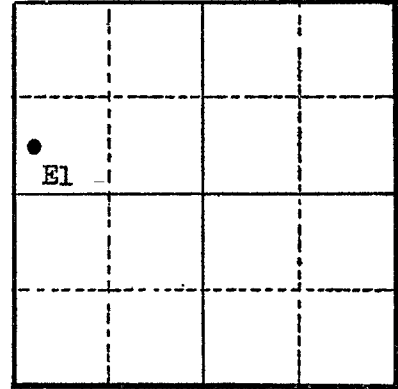

Altitude at well 1260

TYPE OF WELL: Dug Date Constructed Previous to '48

Depth drilled 10 Depth cased 10

Section 1

CASING RECORD:

5 1/2' diameter casing
0 to 4' cement
4 to 10' galvanized steel

FINISH:

AQUIFERS:

WATER LEVEL:

7

PUMPING EQUIPMENT: Type Rainmaster H.P. 11
Capacity 180 G.P.M.

WELL TESTS:

Drawdown 2 ft. after hours 170 G.P.M.

Drawdown ft. after hours G.P.M.

USE OF WATER Irrigation 7 acres Temp. °F., 19

SOURCE OF INFORMATION GR-534

DRILLER or DIGGER

ADDITIONAL DATA:

Log Water Level Measurements Chemical Analysis Aquifer Test

REMARKS:

Sandy loam & clay 0 to 6'
Quicksand & water-bearing gravel 6 to 10'