

STATE ENGINEER  
Salem, Oregon

JACK  
34915

# Well Record


STATE WELL NO. 37/2W-1M(1)  
COUNTY Jackson  
APPLICATION NO. GR-726

OWNER: Walter L. Childress  
MAILING ADDRESS:

LOCATION OF WELL: Owner's No. 1  
CITY AND STATE: Central Point, Oregon

NW 1/4 SW 1/4 Sec. 1 T. 37 N. S. R. 2 W., W.M.

Bearing and distance from section or subdivision  
corner 2205.3' N. & 767.4' E. from SW cor. Sec. 1

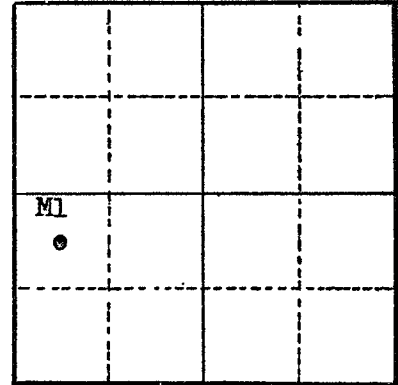

Section 1

Altitude at well 1260' Interpolated

TYPE OF WELL: Dug Date Constructed 1938

Depth drilled 14' Depth cased 13'

### CASING RECORD:

84" concrete from 0 to 13'

### FINISH:

### AQUIFERS:

### WATER LEVEL:

10'

PUMPING EQUIPMENT: Type Elect. mtr. 1.5" cent. H.P. 2  
Capacity 36 G.P.M.

### WELL TESTS:

Drawdown 0 - 0.5 ft. after 36 hours G.P.M.

Drawdown ft. after hours G.P.M.

USE OF WATER Irrigation Temp. °F., 19

SOURCE OF INFORMATION GRO726

DRILLER or DIGGER Tom Harris, Gold Hill

### ADDITIONAL DATA:

Log No Water Level Measurements Chemical Analysis Aquifer Test

### REMARKS: