

STATE ENGINEER
Salem, Oregon

34928

Well Record


STATE WELL NO. 37/2W-2C(1)
COUNTY Jackson
APPLICATION NO. GR-756

OWNER: Willie Germann
MAILING ADDRESS: Route 1, Box 596

LOCATION OF WELL: Owner's No. 1
CITY AND STATE: Central Point, Oregon

NE 1/4 NW 1/4 Sec. 2 T. 37 N. S., R. 2 E. W., W.M.

Bearing and distance from section or subdivision
corner 395' N. & 1595' E. from NW cor. DLG 55

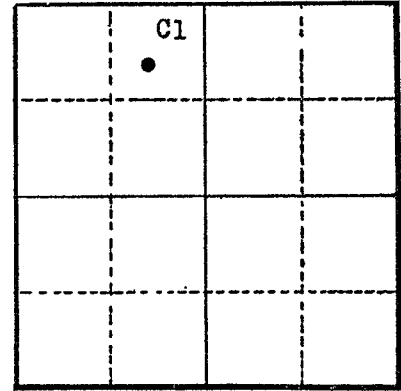

Section 2

Altitude at well 1235' Interpolated

TYPE OF WELL: Dug Date Constructed Spring '49

Depth drilled 16' Depth cased -

CASING RECORD:

none

FINISH:

AQUIFERS:

WATER LEVEL:

12'

PUMPING EQUIPMENT: Type G. E. Weinman Cent. 3" H.P. 20
Capacity 300 G.P.M.

WELL TESTS:

Drawdown _____ ft. after _____ hours _____ G.P.M.
Drawdown _____ ft. after _____ hours _____ G.P.M.

USE OF WATER Irrigation Temp. _____ °F., 19

SOURCE OF INFORMATION GR-756

DRILLER or DIGGER _____

ADDITIONAL DATA:

Log Yes Water Level Measurements _____ Chemical Analysis _____ Aquifer Test _____

REMARKS:

