

STATE ENGINEER
Salem, Oregon

34920

Well Record


STATE WELL NO. 37/2W-2E(1)
COUNTY Jackson
APPLICATION NO. GR-23

OWNER: Willard Ball MAILING ADDRESS: _____

LOCATION OF WELL: Owner's No. 1 CITY AND STATE: Central Point, Oregon

SW $\frac{1}{4}$ NW $\frac{1}{4}$ Sec. 2 T. 37 ^{N.} S., R. 2 ^{E.} W., W.M.

Bearing and distance from section or subdivision corner _____

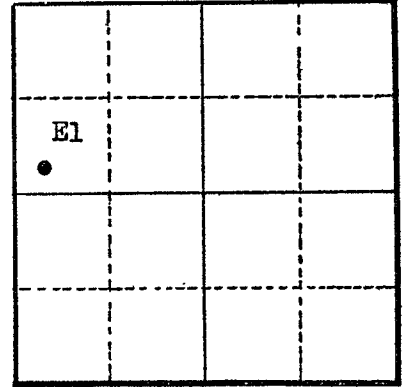

Section 2

Altitude at well 1260' Interpolated

TYPE OF WELL: Sump Date Constructed Oct. '46

Depth drilled 14' Depth cased _____

CASING RECORD:

none

FINISH:

none

AQUIFERS:

WATER LEVEL:
5 feet below land surface

PUMPING EQUIPMENT: Type Weinman 1 1/2" H.P. 5
Capacity 120 G.P.M.

WELL TESTS:
Drawdown _____ ft. after _____ hours _____ G.P.M.
Drawdown _____ ft. after _____ hours _____ G.P.M.

USE OF WATER Irrigation 8 acres Temp. _____ °F., 19 _____

SOURCE OF INFORMATION GR-23

DRILLER or DIGGER _____

ADDITIONAL DATA:
Log No Water Level Measurements _____ Chemical Analysis _____ Aquifer Test _____

REMARKS:

Sump 60 x 35' dug sump