

STATE ENGINEER  
Salem, Oregon

34934

# Well Record

STATE WELL NO. 37/2W-2R(1)  
COUNTY Jackson  
APPLICATION NO. GR-447

OWNER: Richard O. Morelock  
MAILING ADDRESS: General Delivery

CITY AND STATE: Medford, Oregon


LOCATION OF WELL: Owner's No. \_\_\_\_\_  
SE 1/4 SE 1/4 Sec. 2 T. 37 N. S. R. 2 W., W.M.

Bearing and distance from section or subdivision  
corner 1305' N. & 1705' E. from S 1/4 cor. Sec. 2

Altitude at well 1250'

TYPE OF WELL: Drilled Date Constructed June '54

Depth drilled 80 Depth cased 50

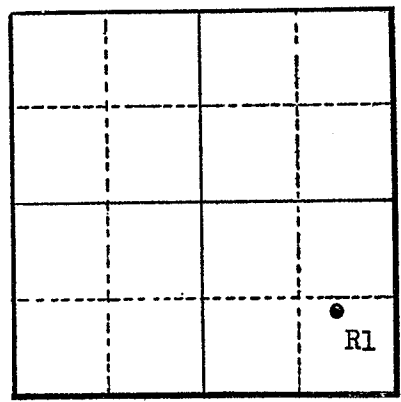

Section 2

CASING RECORD:  
6 inch

FINISH:

AQUIFERS:

WATER LEVEL:  
13

PUMPING EQUIPMENT: Type Jet H.P. 1  
Capacity 45 G.P.M.

WELL TESTS:  
Drawdown \_\_\_\_\_ ft. after \_\_\_\_\_ hours \_\_\_\_\_ G.P.M.  
Drawdown \_\_\_\_\_ ft. after \_\_\_\_\_ hours \_\_\_\_\_ G.P.M.

USE OF WATER Irrigation 3.8 acres Temp. \_\_\_\_\_ °F., 19

SOURCE OF INFORMATION GR-447

DRILLER or DIGGER Virgile Gribble Gold Hill, Oregon

ADDITIONAL DATA:  
Log \_\_\_\_\_ Water Level Measurements \_\_\_\_\_ Chemical Analysis \_\_\_\_\_ Aquifer Test \_\_\_\_\_

REMARKS:  
Log:  
Top soil & sand 0 to 20'  
Concrete gravel (2 strata loose sand & gravel 30' & 50') 20 to 50'  
Shale rock (no casing) 50 to 80'