


STATE ENGINEER
Salem, Oregon

JACK
34936 Well Record

STATE WELL NO. 37/2W-3A(1)
COUNTY Jackson
APPLICATION NO. GR-491

OWNER: A. T. Lathrop
MAILING ADDRESS: Route 1, Box 595
CITY AND STATE: Central Point, Oregon

LOCATION OF WELL: Owner's No. #2
NE 1/4 NE 1/4 Sec. 3 T. 37 S., R. 2 W., W.M.
Bearing and distance from section or subdivision
corner 400' S. & 430' W. from NE cor. Sec. 3

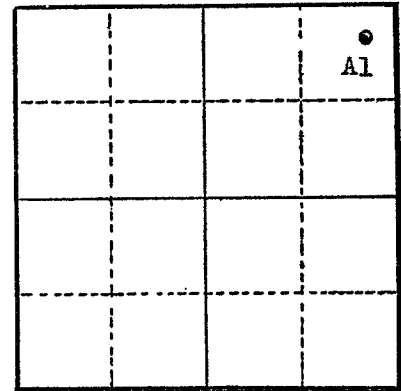

Section 3

Altitude at well 1225

TYPE OF WELL: Dug Date Constructed Aug. '46

Depth drilled 10 Depth cased

CASING RECORD:

30 x 125' sump

FINISH:

AQUIFERS:

WATER LEVEL:

4

PUMPING EQUIPMENT: Type centrifugal H.P. 3
Capacity 250 G.P.M.

WELL TESTS:

Drawdown ft. after hours G.P.M.
Drawdown ft. after hours G.P.M.

USE OF WATER Irrigation 4 acres Temp. °F., 19.

SOURCE OF INFORMATION GR-491

DRILLER or DIGGER

ADDITIONAL DATA:

Log No Water Level Measurements Chemical Analysis Aquifer Test

REMARKS: