

STATE ENGINEER  
Salem, Oregon

JACK  
34937

# Well Record

STATE WELL NO. 37/2W - 3D  
COUNTY JACKSON  
APPLICATION NO. GR-2240

OWNER: Aubrey K. Stith and Emma C. Stith MAILING ADDRESS: 4818 Pacific Hwy. North  
CITY AND STATE: Central Point, Oregon


LOCATION OF WELL: Owner's No. \_\_\_\_\_

SE  $\frac{1}{4}$  NW  $\frac{1}{4}$  NW  $\frac{1}{4}$  Sec. 3 T. 37 N. S., R. 2 E. W., W.M.

Bearing and distance from section or subdivision corner 870' S. and 1510' W.

Altitude at well \_\_\_\_\_

TYPE OF WELL: Dug Date Constructed 1947  
Depth drilled 14 Depth cased 14

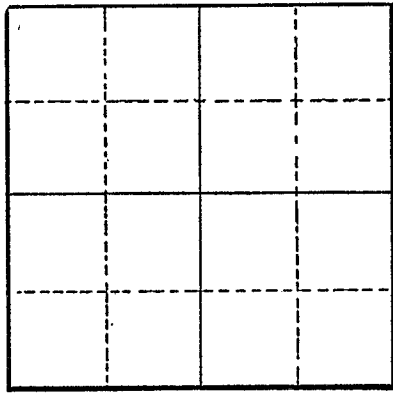

Section \_\_\_\_\_

### CASING RECORD:

30-Inch

### FINISH:

### AQUIFERS:

Gravel and top soil

### WATER LEVEL:

7-Feet

PUMPING EQUIPMENT: Type Centrifugal (Pacific) H.P. 2.5  
Capacity 60 G.P.M.

### WELL TESTS:

Drawdown 2.0 ft. after \_\_\_\_\_ hours Pumping 48 G.P.M.  
Drawdown \_\_\_\_\_ ft. after \_\_\_\_\_ hours \_\_\_\_\_ G.P.M.

USE OF WATER Irrigation Temp. \_\_\_\_\_ °F. \_\_\_\_\_, 19.

SOURCE OF INFORMATION GR-2141

DRILLER or DIGGER By claimant

### ADDITIONAL DATA:

Log  Water Level Measurements \_\_\_\_\_ Chemical Analysis \_\_\_\_\_ Aquifer Test \_\_\_\_\_

### REMARKS:

Top soil 12 2  
Medium Gravel (Water bearing) 2 0