

STATE ENGINEER
Salem, Oregon

JACK
34938 Well Record


STATE WELL NO. 37/2W-3G(1)
COUNTY Jackson
APPLICATION NO. GR-183

OWNER: Edward G. & Clara E. Miller MAILING ADDRESS: Route 1, Box 574

LOCATION OF WELL: Owner's No. #1 CITY AND STATE: Central Point, Oregon

SW 1/4 NE 1/4 Sec. 3 T. 37 S., R. 2 W., W.M.

Bearing and distance from section or subdivision corner 1770' S. & 185' E. from N1/4 cor. Sec. 3

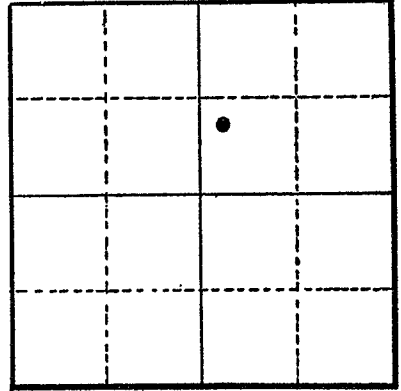

Section 3

Altitude at well 1220' Interpolated

TYPE OF WELL: Drilled Date Constructed Aug. 55

Depth drilled 37' Depth cased 37'

CASING RECORD:

24 inch concrete tile set from 0 to 37'

FINISH:

10 inch perforations in tile per foot from 28 to 37'

AQUIFERS:

unknown

WATER LEVEL:

8.0 feet below land surface

PUMPING EQUIPMENT: Type 1.5" centrifugal H.P. 3

Capacity 30 G.P.M.

WELL TESTS:

Drawdown 10 ft. after pumping 20 hours G.P.M.

Drawdown ft. after hours G.P.M.

USE OF WATER Irrigation 1 acre Temp. °F. 19

SOURCE OF INFORMATION GR-183

DRILLER or DIGGER R. J. Shand add. unknown

ADDITIONAL DATA:

Log No Water Level Measurements Chemical Analysis Aquifer Test

REMARKS: