

STATE ENGINEER
Salem, Oregon


BACK
349/40 Well Record

STATE WELL NO. 37/2W-30
COUNTY JACKSON
APPLICATION NO. GR-2396

OWNER: Thomas G. Vella, DBA Rogue River Valley Creamery
MAILING ADDRESS: Central Point,
CITY AND STATE: Oregon

LOCATION OF WELL: Owner's No. #2
SW 1/4 SE 1/4 Sec. 3 T. 37 N S, R. 2 E W., W.M.

Bearing and distance from section or subdivision corner 627' N. and 927' E.

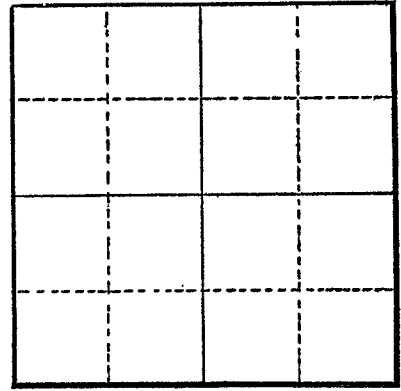

Section

Altitude at well

TYPE OF WELL: Drilled Date Constructed 1954

Depth drilled 121 Depth cased 41

CASING RECORD:

12-inch

FINISH:

AQUIFERS:

WATER LEVEL:
18-feet

PUMPING EQUIPMENT: Type Pacific Beresford Model 15 A22 H.P. 4
Capacity 27.7 G.P.M.

WELL TESTS:
Drawdown 116 ft. after hours Pumping 16 G.P.M.
Drawdown ft. after hours G.P.M.

USE OF WATER Manufacturing Temp. °F., 19

SOURCE OF INFORMATION GR-2277

DRILLER or DIGGER Goff Brothers, Medford, Oregon

ADDITIONAL DATA:
Log Water Level Measurements Chemical Analysis Aquifer Test

REMARKS: