

STATE ENGINEER
Salem, Oregon

34940 JACK

Well Record

STATE WELL NO. 37/2W-30
COUNTY JACKSON
APPLICATION NO. GR-2395

OWNER: Thomas G. Vella, DBA Rogue River Valley Creamery


MAILING ADDRESS: Central Point,

LOCATION OF WELL: Owner's No. #1

CITY AND STATE: Oregon

SW 1/4 SE 1/4 Sec. 3 T. 37 S., R. 2 W., W.M.

Bearing and distance from section or subdivision corner 605' N. and 943' E.

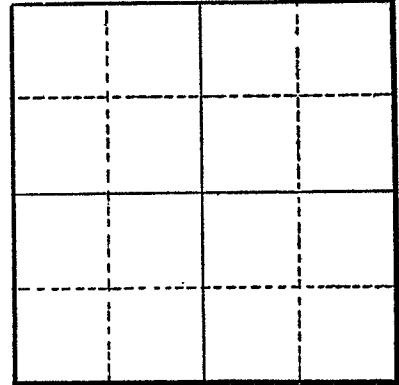

Section

Altitude at well

TYPE OF WELL: Drilled Date Constructed 1952

Depth drilled 124 Depth cased 92

CASING RECORD:

6-inch

FINISH:

AQUIFERS:

WATER LEVEL:

18-feet

PUMPING EQUIPMENT: Type Peerless Hi-Lift Model 52 A H.P. 5
Capacity 60 G.P.M.

WELL TESTS:

Drawdown 118 ft. after hours Pumping 32 G.P.M.
Drawdown ft. after hours G.P.M.

USE OF WATER Manufacturing Temp. °F., 19

SOURCE OF INFORMATION GR-2276

DRILLER or DIGGER Goff Brothers, Medford, Oregon

ADDITIONAL DATA:

Log Water Level Measurements Chemical Analysis Aquifer Test

REMARKS: