

STATE ENGINEER  
Salem, Oregon

JACK  
34957 Well Record

STATE WELL NO. 37/2W-9C  
COUNTY Jackson  
APPLICATION NO. GR-1602

GR-1554

OWNER: G. Alvin Roberts


MAILING ADDRESS: Rt. 1, Box 225

LOCATION OF WELL: Owner's No.

CITY AND STATE: Central Point, Oregon

NE 1/4 NW 1/4 Sec. 9 T. 37 S., R. 2 W., W.M.

Bearing and distance from section or subdivision corner 1704' S. & 1493' E. from NW cor. DIC #45

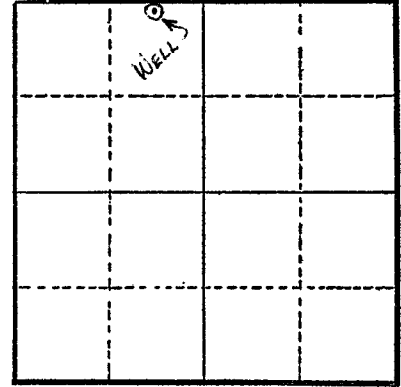

Section 9

Altitude at well 1270'

TYPE OF WELL: Drilled Date Constructed 1955

Depth drilled 15' Depth cased 15'

CASING RECORD:

24" concrete tile

FINISH:

Perforated: 3" - 10 per ft. from 4 to 15 ft.

AQUIFERS:

Granite

WATER LEVEL:

2'

PUMPING EQUIPMENT: Type 1" Cent. H.P. 1/2  
Capacity 20 G.P.M.

WELL TESTS:

Drawdown 4 ft. after 20 hours G.P.M.  
Drawdown ft. after hours G.P.M.

USE OF WATER Irrigation Temp. °F., 19.

SOURCE OF INFORMATION GR Record

DRILLER or DIGGER Rob. Shands

ADDITIONAL DATA:

Log Water Level Measurements Chemical Analysis Aquifer Test

REMARKS:

Log: Clay 0 to 10 ft.  
Granite (water) 10 to 15 ft.

Irrigation of 2 acres.