

STATE ENGINEER  
Salem, Oregon

# Well Record

STATE WELL NO: <sup>37</sup>/2W - 9R  
COUNTY JACKSON  
APPLICATION NO. GR-1958

34959

OWNER: Walter P. Mang


MAILING ADDRESS: 3123 Linden Lane

LOCATION OF WELL: Owner's No. Sump

CITY AND STATE: Central Point, Oregon

SE 1/4 SE 1/4 Sec. 9 T. 37 S., R. 2 W., W.M.

Bearing and distance from section or subdivision corner 515' N. & 385' W. of Sec. Corner 9-10-15-16

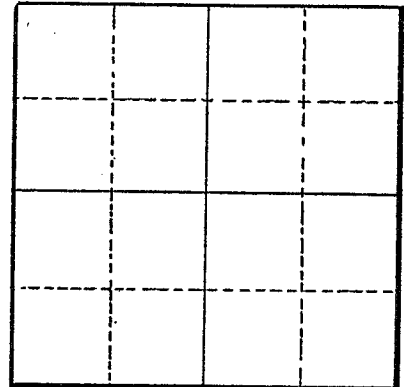

Altitude at well \_\_\_\_\_

TYPE OF WELL: Dug Date Constructed 1953

Depth drilled \_\_\_\_\_ Depth cased \_\_\_\_\_

Section \_\_\_\_\_

CASING RECORD:

FINISH:

AQUIFERS:

WATER LEVEL:

PUMPING EQUIPMENT: Type Centrifugal pump (Berkeley) H.P. 5  
Capacity 112 G.P.M.

WELL TESTS:  
Drawdown \_\_\_\_\_ ft. after \_\_\_\_\_ hours \_\_\_\_\_ G.P.M.  
Drawdown \_\_\_\_\_ ft. after \_\_\_\_\_ hours \_\_\_\_\_ G.P.M.

USE OF WATER Irrigation Temp. \_\_\_\_\_ °F. \_\_\_\_\_, 19\_\_\_\_

SOURCE OF INFORMATION GR-1884

DRILLER or DIGGER Tru. Mix Concrete Company, Medford, Oregon

ADDITIONAL DATA:  
Log \_\_\_\_\_ Water Level Measurements \_\_\_\_\_ Chemical Analysis \_\_\_\_\_ Aquifer Test \_\_\_\_\_

REMARKS:

Sump