


STATE ENGINEER
Salem, Oregon

JACK 34960
JACK 34960 Well Record

STATE WELL NO. 37/2W-17
COUNTY JACKSON
APPLICATION NO. GR-2736

OWNER: Thomas J. Hight and Gertrude M. Hight
MAILING ADDRESS: Rt. 1, Box 457-N
CITY AND STATE: Medford, Oregon

LOCATION OF WELL: Owner's No. 17
1/4 Sec. 17 T. 37 S., R. 2 W., W.M.
Bearing and distance from section or subdivision corner 150' S., 100' E.

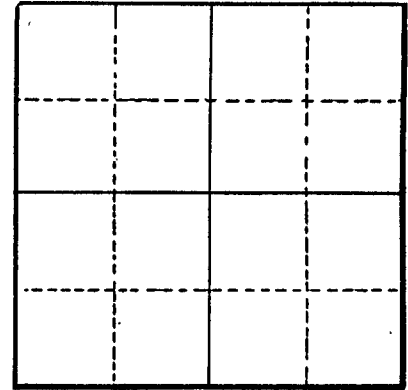

Section

Altitude at well

TYPE OF WELL: drilled Date Constructed 1944

Depth drilled 231 Depth cased 50

CASING RECORD:

6-inch

FINISH:

AQUIFERS:

Granite

WATER LEVEL:

PUMPING EQUIPMENT: Type Fairbanks Morse Turbine H.P. 5
Capacity 50 G.P.M.

WELL TESTS:
Drawdown 200 ft. after hours Pumping 25 G.P.M.
Drawdown ft. after hours G.P.M.

USE OF WATER irrigation Temp. °F., 19

SOURCE OF INFORMATION GR-2589

DRILLER or DIGGER Bob Burns, Grants Pass, Oregon

ADDITIONAL DATA:

Log X Water Level Measurements Chemical Analysis Aquifer Test

REMARKS:

Decomposed granite and granite diorite.