

STATE ENGINEER
Salem, Oregon

Jack
34963

Well Record

STATE WELL NO. 37/1W-31E
COUNTY Jackson
APPLICATION NO. GR-1682

GR-1632

OWNER: Harry & David, An Oregon Corp.


MAILING ADDRESS: P. O. Box 712

LOCATION OF WELL: Owner's No. _____

CITY AND STATE: Medford, Oregon

SW $\frac{1}{4}$ NW $\frac{1}{4}$ Sec. 31 T. 37 S., R. 1 W., W.M.

Bearing and distance from section or subdivision corner 670' S. & 1655' E. from NW cor. DIC #85

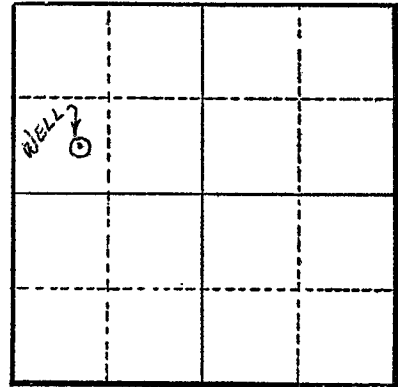

Section 31

Altitude at well 1410'

TYPE OF WELL: Dug Date Constructed 1942

Depth drilled 14' Depth cased 14'

CASING RECORD:
36" concrete tile

FINISH:

AQUIFERS:

WATER LEVEL:
10'

PUMPING EQUIPMENT: Type Pacific 1 1/2" Cent. H.P. 3/4
Capacity 60 G.P.M.

WELL TESTS:
Drawdown 3 ft. after _____ hours 60 G.P.M.
Drawdown _____ ft. after _____ hours _____ G.P.M.

USE OF WATER Industrial Temp. _____ °F., 19 _____

SOURCE OF INFORMATION GR Record

DRILLER or DIGGER Bear Creek Orchard Employees

ADDITIONAL DATA:

Log N.A. Water Level Measurements _____ Chemical Analysis _____ Aquifer Test _____

REMARKS: