

STATE ENGINEER
Salem, Oregon

Jack
34966

Well Record

STATE WELL NO. 37/1W-34H(1)
COUNTY Jackson
APPLICATION NO. GR-728

OWNER: S. E. Hansen


MAILING ADDRESS: Route 3, Box 197

LOCATION OF WELL: Owner's No. 1

CITY AND STATE: Medford, Oregon

SE 1/4 NE 1/4 Sec. 34 T. 37 S., R. 1 W., W.M.

Bearing and distance from section or subdivision corner 1027' N & 1383' E from SW cor. DLC 56

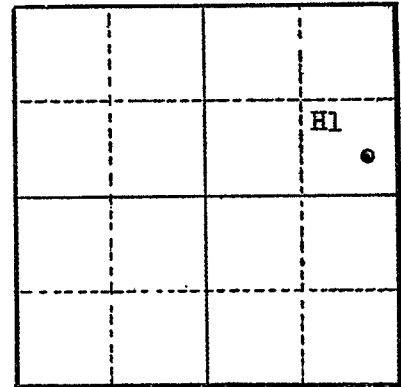

Altitude at well 1660' Interpolated

TYPE OF WELL: Dug Date Constructed Oct. 18 '52

Depth drilled 20 Depth cased none

Section 34

CASING RECORD:

no casing

FINISH:

AQUIFERS:

WATER LEVEL:

4'

PUMPING EQUIPMENT: Type Elect. cornell centrifugal 2 1/2" H.P. 7 1/2
Capacity 108 G.P.M.

WELL TESTS:

Drawdown ft. after hours G.P.M.
Drawdown ft. after hours G.P.M.

USE OF WATER Irrigation Temp. °F., 19.....

SOURCE OF INFORMATION GR-728

DRILLER or DIGGER

ADDITIONAL DATA:

Log Water Level Measurements Chemical Analysis Aquifer Test

REMARKS:

