

STATE ENGINEER
Salem, Oregon

JACK
34985

Well Record

STATE WELL NO. 37/2W-20B(2)
COUNTY Jackson
APPLICATION NO. GR-643

OWNER: Houston R. Pitts


MAILING ADDRESS: Route 2, Box 457-D

LOCATION OF WELL: Owner's No. 1

CITY AND STATE: Medford Oregon

NW 1/4 NE 1/4 Sec. 20 T. 37 N. S., R. 2 E. W., W.M.

Bearing and distance from section or subdivision
corner 642' S. & 11' E. from N1/4 cor., Sec. 20

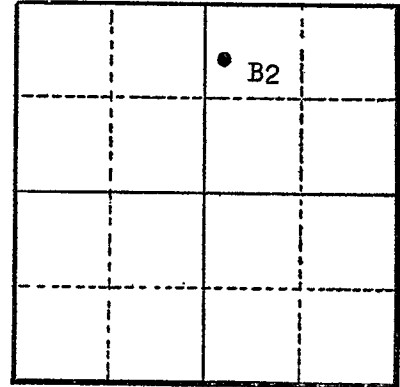

Altitude at well 1640' Interpolated

TYPE OF WELL: Drilled Date Constructed Nov. 15 '46

Depth drilled 202 Depth cased 30

Section 20

CASING RECORD:

8 inch

FINISH:

AQUIFERS:

WATER LEVEL:

30 feet

PUMPING EQUIPMENT: Type _____ H.P. 5
Capacity _____ G.P.M.

WELL TESTS:

Drawdown 10 ft. after _____ hours 80 G.P.M.

Drawdown _____ ft. after _____ hours _____ G.P.M.

USE OF WATER Irrigation 10 acres Temp. _____ °F. 19

SOURCE OF INFORMATION GR-643

DRILLER or DIGGER Robert Burns, Grants Pass, Oregon

ADDITIONAL DATA:

Log _____ Water Level Measurements _____ Chemical Analysis _____ Aquifer Test _____

REMARKS:

Tombstone granite 0 to 172'
Loose formation of decomposed granite & dirt 172-202'