

STATE ENGINEER
Salem, Oregon

JACK
34996

Well Record


STATE WELL NO. 37/2W-21A(1)
COUNTY Jackson
APPLICATION NO. GR-279

OWNER: Katheryn Hanley Heffernan MAILING ADDRESS: Route 2, Box 401

LOCATION OF WELL: Owner's No. #1 CITY AND STATE: Medford, Oregon

NE 1/4 NE 1/4 Sec. 21 T. 37 S., R. 2 W., W.M.

Bearing and distance from section or subdivision corner N 00° 30' E 240' to the section cor. common to 15,16,21, 22

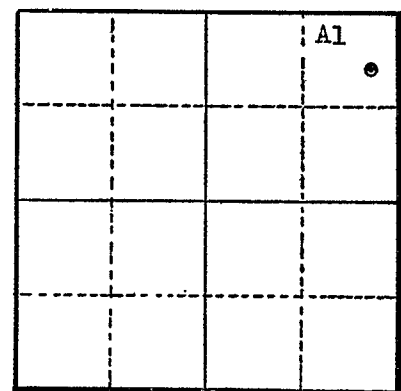

Section 21

Altitude at well Interpolated

TYPE OF WELL: Dug Date Constructed Aug. '47

Depth drilled 12 Depth cased

CASING RECORD:

Open sump pit 100' long 70' wide 8-12 feet deep

FINISH:

none

AQUIFERS:

unknown

WATER LEVEL:

PUMPING EQUIPMENT: Type Yager H.P. 10
Capacity 200 G.P.M.

WELL TESTS:

Drawdown ft. after hours G.P.M.
Drawdown ft. after hours G.P.M.

USE OF WATER Irrigation 20 acres Temp. °F., 19

SOURCE OF INFORMATION GR-279

DRILLER or DIGGER

ADDITIONAL DATA:

Log No Water Level Measurements Chemical Analysis Aquifer Test

REMARKS: