

STATE ENGINEER  
Salem, Oregon

JACK  
34999

# Well Record

STATE WELL NO. 37/2W-21H(1)  
COUNTY Jackson  
APPLICATION NO. GR-279

OWNER: Katheryn Hanley Heffernan

MAILING ADDRESS:

Route 2, Box 401

LOCATION OF WELL: Owner's No. #3


CITY AND STATE:

Medford, Oregon

SE 1/4 NE 1/4 Sec. 21 T. 37 N. S., R. 2 W., W.M.

Bearing and distance from section or subdivision

corner 1909.0' N. 14° 30' E. to the Section corner common to 15,16,21,22 or NE cor. Sec. 21

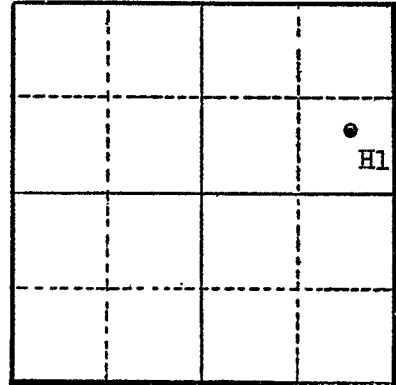

Section 21

Altitude at well Interpolated

TYPE OF WELL: Dug Date Constructed Aug. '51

Depth drilled 15 Depth cased

### CASING RECORD:

None Sump pip 75' long 60' wide 8-15' deep

### FINISH:

none

### AQUIFERS:

unknown

### WATER LEVEL:

PUMPING EQUIPMENT: Type Wisconsin portable - cent. ?? H.P. 1-  
Capacity 200 G.P.M.

### WELL TESTS:

Drawdown ft. after hours G.P.M.

Drawdown ft. after hours G.P.M.

USE OF WATER Irrigation 15 acres Temp. °F., 19

SOURCE OF INFORMATION GR-279

DRILLER or DIGGER

### ADDITIONAL DATA:

Log No Water Level Measurements Chemical Analysis Aquifer Test

### REMARKS: