

STATE ENGINEER
Salem, Oregon

JACK
35000

Well Record

STATE WELL NO. 37/2W-21H(2)
COUNTY Jackson
APPLICATION NO. GR-279

OWNER: Katheryn Hanley Heffernan


MAILING ADDRESS: Route 2, Box 401

LOCATION OF WELL: Owner's No. #2

CITY AND STATE: Medford, Oregon

SE 1/4 NE 1/4 Sec. 21 T. 37 N. S. R. 2 E. W. W.M.

Bearing and distance from section or subdivision corner N 13° 00' E 1431.8' to the section corner common to sections 15 & 16 21& 22 or NE cor. Sec. 21

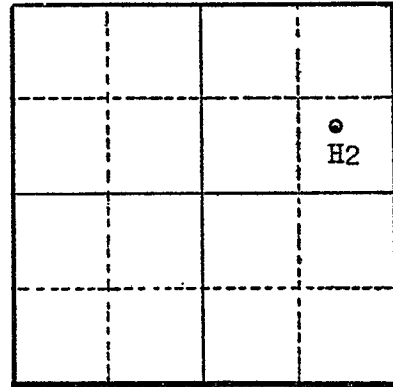

Section

Altitude at well Interpolated

TYPE OF WELL: dug Date Constructed Aug. '47

Depth drilled 15 Depth cased

CASING RECORD:

Open sump pit 200' long 75' wide 10-15' deep

FINISH:

none

AQUIFERS:

unknown

WATER LEVEL:

PUMPING EQUIPMENT: Type Portable Rain o flow H.P. 5
Capacity 200 ? G.P.M.

WELL TESTS:

Drawdown ft. after hours G.P.M.
Drawdown ft. after hours G.P.M.

USE OF WATER Irrigation 28.7 acres Temp. °F. , 19

SOURCE OF INFORMATION GR-279

DRILLER or DIGGER

ADDITIONAL DATA:

Log No Water Level Measurements Chemical Analysis Aquifer Test

REMARKS: