

STATE ENGINEER
Salem, Oregon

JACK
3500

Well Record

STATE WELL NO. 37/2W-21H(3)
COUNTY Jackson
APPLICATION NO. GR-279

OWNER: Katheryn Hanley Heffernan

MAILING ADDRESS:

Route 2, Box 401


LOCATION OF WELL: Owner's No. 4

CITY AND STATE:

Medford, Oregon

SE ¼ SE ¼ Sec. 21 T. 37 ^{N.} S., R. 2 ^{E.} W., W.M.

Bearing and distance from section or subdivision corner

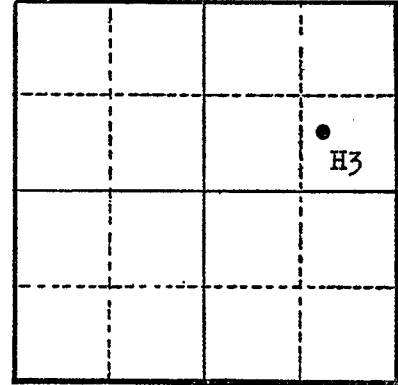

Altitude at well Interpolated

TYPE OF WELL: Dug Date Constructed Aug. '50

Depth drilled 20 Depth cased

Section 21

CASING RECORD:

Sump pit 50' long 50' wide 12-20' deep

FINISH:

none

AQUIFERS:

unknown

WATER LEVEL:

PUMPING EQUIPMENT: Type Wisconsin Portable H.P. 10
Capacity 200 G.P.M.

WELL TESTS:

Drawdown ft. after hours G.P.M.

Drawdown ft. after hours G.P.M.

USE OF WATER Irrigation 11.1 acres Temp. °F., 19.....

SOURCE OF INFORMATION GR-279

DRILLER or DIGGER

ADDITIONAL DATA:

Log no Water Level Measurements Chemical Analysis Aquifer Test

REMARKS: