

STATE ENGINEER
Salem, Oregon

*JACK
35003*

Well Record

STATE WELL NO. 37/2W-21R(1)
COUNTY Jackson
APPLICATION NO. GR-280

OWNER: Katheryn Hanley Heffernan


MAILING ADDRESS: Route 2, Box 401

LOCATION OF WELL: Owner's No. #5

CITY AND STATE: Medford, Oregon

SE 1/4 SE 1/4 Sec. 21 T. 37 S., R. 2 W., W.M.

Bearing and distance from section or subdivision corner 653.4' S. 61° E of SE cor. Sec. 28

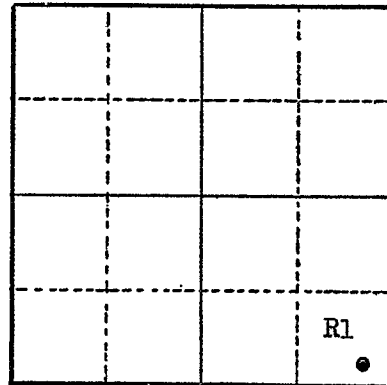

Section 21

Altitude at well Interpolated

TYPE OF WELL: Dug Date Constructed Aug. '51

Depth drilled 25 Depth cased _____

CASING RECORD:

Sump pit 140' long 40' wide 18-25' deep

FINISH:

none

AQUIFERS:

unknown

WATER LEVEL:

PUMPING EQUIPMENT: Type Parma water lifter #4 H.P. 10
Capacity 450 G.P.M.

WELL TESTS:

Drawdown _____ ft. after _____ hours pumping 450 G.P.M.

Drawdown _____ ft. after _____ hours _____ G.P.M.

USE OF WATER Irrigation 36.4 acres Temp. _____ °F., 19 _____

SOURCE OF INFORMATION GR-280

DRILLER or DIGGER _____

ADDITIONAL DATA:

Log no Water Level Measurements _____ Chemical Analysis _____ Aquifer Test _____

REMARKS: