

STATE ENGINEER
Salem, Oregon

JACK
35008

Well Record

STATE WELL NO. 37/2W-22C(2)
COUNTY Jackson
APPLICATION NO. GR-7

OWNER: J. C. Boyle

MAILING ADDRESS:

Route 2, Box 495


LOCATION OF WELL: Owner's No. #2

CITY AND STATE:

Medford, Oregon

NE 1/4 NW 1/4 Sec. 22 T. 37 N. S. R. 2 E. W., W.M.

Bearing and distance from section or subdivision corner 285' E of Central Point Hwy. & 160' N of Ross Lane

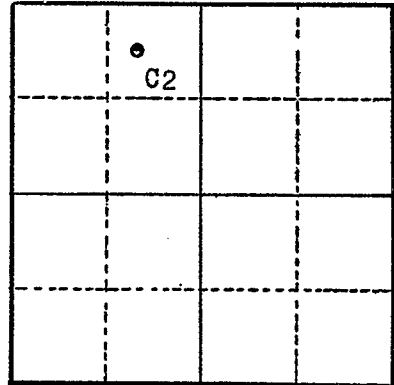

Section 22

Altitude at well 1250' Interpolated

TYPE OF WELL: Drilled Date Constructed June '52

Depth drilled 70' Depth cased 20'

CASING RECORD:

6 inch casing set from 0 to 20 feet

FINISH:

none

AQUIFERS:

weathered granite (sand) 20 to 70 feet

WATER LEVEL:

12 feet below land surface No. 1955

PUMPING EQUIPMENT: Type Pacific Beresford Submersible H.P. 2
Capacity G.P.M.

WELL TESTS:

Drawdown 30 ft. after 45 hours G.P.M.
Drawdown ft. after hours G.P.M.

USE OF WATER Temp. °F., 19

SOURCE OF INFORMATION GR-7

DRILLER or DIGGER

ADDITIONAL DATA:

Log Water Level Measurements Chemical Analysis Aquifer Test

REMARKS: second of three wells

Log: 0 to 6' loam sandy black
6 to 20' sand, granite
20 to 70' hardpan "sandstone" granite