

STATE ENGINEER
Salem, Oregon

JACK
3500g

Well Record

STATE WELL NO. 37/2W-22C(3)
COUNTY Jackson
APPLICATION NO. GR-7


OWNER: J. C. Boyle

MAILING ADDRESS: Route 2, Box 495

LOCATION OF WELL: Owner's No. #3

CITY AND STATE: Medford, Oregon

NE 1/4 NW 1/4 Sec. 22 T. 37 N. S., R. 2 E. W., W.M.

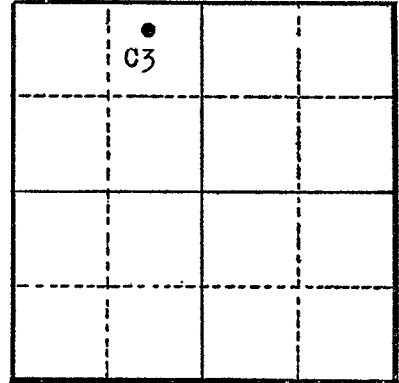

Bearing and distance from section or subdivision corner 440' E. of Central Point Hwy. & 176' N. of Ross Lane or 1100' S. of north line of DLG-69

Altitude at well 1250' Interpolated

TYPE OF WELL: Drilled Date Constructed June '55

Depth drilled 100' Depth cased 20'

Section 22

CASING RECORD:

6 inch steel casing set from 0 to 20 feet

FINISH:

none

AQUIFERS:

weathered granite (sand) from to to 100'

WATER LEVEL:

13 feet below land surface

PUMPING EQUIPMENT: Type Jacuzzi jet 3VHHE WGD 23 H.P. 3
Capacity G.P.M.

WELL TESTS:

Drawdown 40 ft. after 35 hours G.P.M.
Drawdown ft. after hours G.P.M.

USE OF WATER Domestic & Irrigation Temp. °F., 19

SOURCE OF INFORMATION GR-7

DRILLER or DIGGER

ADDITIONAL DATA:

Log Water Level Measurements Chemical Analysis Aquifer Test

REMARKS:

Log: 0 to 6' loam, sandy
6 to 20' sand, granite
20-100' sandstone, granite