

STATE ENGINEER
Salem, Oregon

JACK
35010 Well Record


STATE WELL NO. 37/2W-22M(1)
COUNTY Jackson
APPLICATION NO. GR-280

OWNER: Katheryn Hanley Hefferman MAILING ADDRESS: Route 2, Box 401

LOCATION OF WELL: Owner's No. #6 CITY AND STATE: Medford, Oregon

NW 1/4 SW 1/4 Sec. 22 T. 37 N. S. R. 2 W., W.M.

Bearing and distance from section or subdivision corner 1900' S. 20° W. to the SW cor. Sec. 22

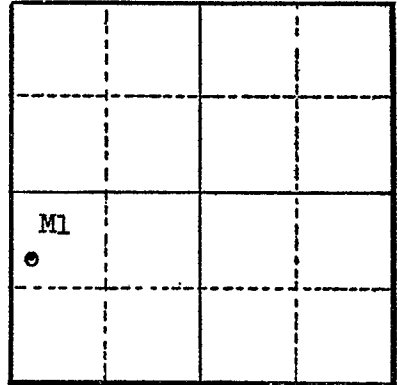

Section 22

Altitude at well Interpolated

TYPE OF WELL: Dug Date Constructed Aug. '49

Depth drilled 18 Depth cased

CASING RECORD:

Sump Pit 50' long, 25' wide 12 to 18' deep

FINISH:

none

AQUIFERS:

unknown

WATER LEVEL:

PUMPING EQUIPMENT: Type Portable Rain-o-flow H.P. 5
Capacity 200 G.P.M.

WELL TESTS:

Drawdown ft. after hours G.P.M.
Drawdown ft. after hours G.P.M.

USE OF WATER Irrigation 14.3 acres Temp. °F. 19

SOURCE OF INFORMATION GR-280

DRILLER or DIGGER

ADDITIONAL DATA:

Log no Water Level Measurements Chemical Analysis Aquifer Test

REMARKS: