

STATE ENGINEER
Salem, Oregon

35012 Well Record

STATE WELL NO. 37/2W-23g(1)
COUNTY Jackson
APPLICATION NO. GR-151

OWNER: Anna G. Brewer


MAILING ADDRESS:

LOCATION OF WELL: Owner's No. 1

CITY AND STATE: Medford, Oregon

SW 1/4 NE 1/4 Sec. 23 T. 37 N. S. R. 2 W., W.M.

Bearing and distance from section or subdivision corner 2300' W. & 1400' S. from NE cor. Sec. 23

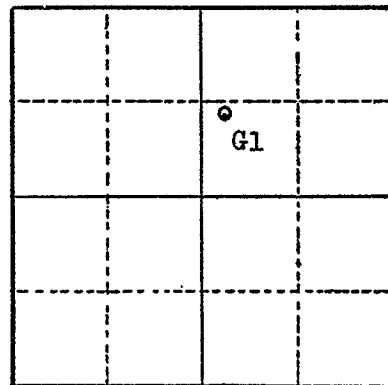

Section 23

Altitude at well 1350' Interpolated

TYPE OF WELL: ^{Sump} Dug Date Constructed 4/1/51

Depth drilled 4 to 9' Depth cased Trench

CASING RECORD:

none

FINISH:

none

AQUIFERS:

unknown

WATER LEVEL:

2-3 feet below land surface

PUMPING EQUIPMENT: Type Cornell centrifugal 1 1/2" H.P. 5
Capacity 600?? G.P.M.

WELL TESTS:

Drawdown ft. after hours G.P.M.
Drawdown ft. after hours G.P.M.

USE OF WATER Irrigation 4 acres Temp. °F., 19

SOURCE OF INFORMATION GR-151

DRILLER or DIGGER

ADDITIONAL DATA:

Log No Water Level Measurements Chemical Analysis Aquifer Test

REMARKS: