

JACK 35048

STATE ENGINEER
Salem, Oregon

JACK
35048

Well Record

GR- 1663

STATE WELL NO. 38/1W-5F
COUNTY Jackson
APPLICATION NO. GR- 1714

OWNER: Harry & David, An Oregon Corp.


MAILING ADDRESS: P. O. Box 712

LOCATION OF WELL: Owner's No. Edmund's

CITY AND STATE: Medford, Oregon

SE 1/4 NW 1/4 Sec. 5 T. 38 S., R. 1 W., W.M.

Bearing and distance from section or subdivision corner 1655' N. & 1685' E. from NE cor. DLC #47

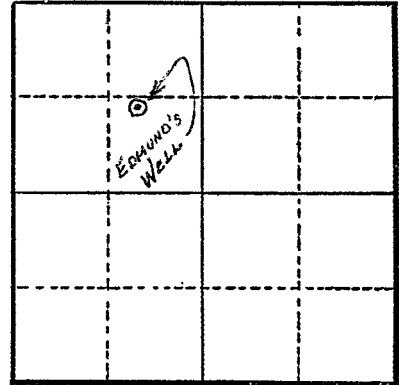

Section 5

Altitude at well 1410'

TYPE OF WELL: Drilled Date Constructed 1946

Depth drilled 125' Depth cased ?

CASING RECORD:

8"

FINISH:

AQUIFERS:

WATER LEVEL:

12'

PUMPING EQUIPMENT: Type Shasta submersible 2" H.P. 5
Capacity 65 G.P.M.

WELL TESTS:

Drawdown 0 ft. after 22 hours G.P.M.

Drawdown ft. after hours G.P.M.

USE OF WATER Manufacturing & Domestic Temp. °F. 19

SOURCE OF INFORMATION GR Record

DRILLER or DIGGER

ADDITIONAL DATA:

Log N.A. Water Level Measurements Chemical Analysis Aquifer Test

REMARKS: