

STATE ENGINEER
Salem, Oregon

JACK 35050
Well Record

STATE WELL NO. 38/1W-6A
COUNTY Jackson
APPLICATION NO. GR-1712

GR- 1661

OWNER: Harry & David, An Oregon Corp.

MAILING ADDRESS: P. O. Box 712


LOCATION OF WELL: Owner's No. #4

CITY AND STATE: Medford, Oregon

NE 1/4 NE 1/4 Sec. 6 T. 38 S., R. 1 W., W.M.

Bearing and distance from section or subdivision

corner 615' N. & 2305' E. from SW cor. DIC #54

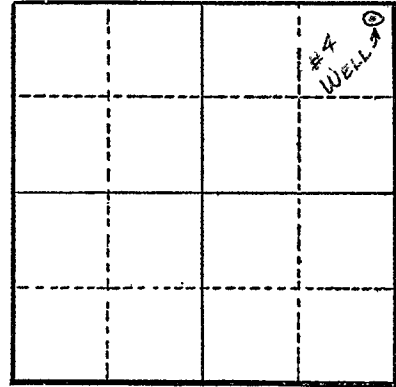

Section 6

Altitude at well 1410'

TYPE OF WELL: Dug Date Constructed Prior to 1900

Depth drilled 30' Depth cased Tunnel

CASING RECORD:

Tunnel- 100' long, 7' x 7' straight & 96" in diameter

FINISH:

AQUIFERS:

WATER LEVEL:

12'

PUMPING EQUIPMENT: Type Deming 5 1/2" x 5 1/2" Recip. & Meyers 3" x 10" H.P. 1 & 1 1/2
Capacity 50 & 30 G.P.M.

WELL TESTS:

Drawdown 28 ft. after 80 hours G.P.M.

Drawdown ft. after hours G.P.M.

USE OF WATER Manufacturing & Domestic Temp. °F., 19

SOURCE OF INFORMATION GR Record

DRILLER or DIGGER

ADDITIONAL DATA:

Log N.A. Water Level Measurements Chemical Analysis Aquifer Test

REMARKS: