

STATE ENGINEER  
Salem, Oregon

**JACK 35051**  
*JACK*  
**Well Record**  
*35051*

STATE WELL NO. 38/1W-6B  
COUNTY Jackson  
APPLICATION NO. GR-1711

GR- 1660

OWNER: Harry & David, An Oregon Corp.


MAILING ADDRESS: P.O. Box 712

LOCATION OF WELL: Owner's No. \_\_\_\_\_

CITY AND STATE: Medford, Oregon

NW 1/4 NE 1/4 Sec. 6 T. 38 S., R. 1 W., W.M.

Bearing and distance from section or subdivision  
corner 90' S. & 1160' E. from SW cor. DIC #54

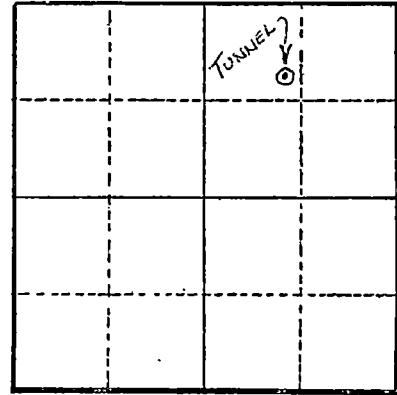

Altitude at well 1410'

TYPE OF WELL: Dug Date Constructed 1900-Prior to

Depth drilled 30' Depth cased Tunnel

Section 6

CASING RECORD:

Tunnel- 40' long 7' x 7' straight & 36" diameter

FINISH:

AQUIFERS:

WATER LEVEL:

12'

PUMPING EQUIPMENT: Type Wesco 2" Cent. H.P. 5

Capacity 50 G.P.M.

WELL TESTS:

Drawdown 28 ft. after \_\_\_\_\_ hours 50 G.P.M.

Drawdown \_\_\_\_\_ ft. after \_\_\_\_\_ hours \_\_\_\_\_ G.P.M.

USE OF WATER Manufacturing & Domestic Temp. \_\_\_\_\_ °F., 19\_\_\_\_\_

SOURCE OF INFORMATION GR Record

DRILLER or DIGGER \_\_\_\_\_

ADDITIONAL DATA:

Log N.A. Water Level Measurements \_\_\_\_\_ Chemical Analysis \_\_\_\_\_ Aquifer Test \_\_\_\_\_

REMARKS: