

STATE ENGINEER
Salem, Oregon

JACK 35057
JACK
35057
Well Record


STATE WELL NO. 38/1W-10P(1)
COUNTY Jackson
APPLICATION NO. GR-664

OWNER: Paul W. Steveson
MAILING ADDRESS: Box 132

LOCATION OF WELL: Owner's No. 1
CITY AND STATE: Phoenix, Oregon

SE 1/4 SW 1/4 Sec. 10 T. 38 N. S., R. 1 E. W., W.M.

Bearing and distance from section or subdivision
corner 840' N. & 1425' E. from SW cor. Sec. 10

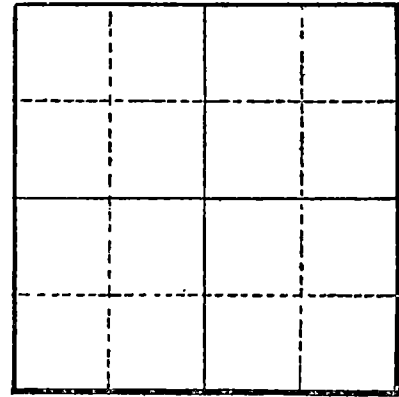

Section 10

Altitude at well 1545' Interpolated

TYPE OF WELL: Dug Date Constructed 2/10/47

Depth drilled 20 Depth cased

CASING RECORD:

370' x 40' x 20' deep sump

FINISH:

AQUIFERS:

WATER LEVEL:

10 feet

PUMPING EQUIPMENT: Type Centrifugal H.P. 60
Capacity 200 G.P.M.

WELL TESTS:

Drawdown 10 ft. after hours G.P.M.

Drawdown ft. after hours G.P.M.

USE OF WATER Irrigation 25 acres Temp. °F., 19

SOURCE OF INFORMATION GR-664

DRILLER or DIGGER Virgil O. Anderson Medford, Oregon

ADDITIONAL DATA:

Log Water Level Measurements Chemical Analysis Aquifer Test

REMARKS:

Gravel & rock (water bearing after 10 feet) 0 to 18'
Sandy loam 18 to 20'