

JACK 35059

STATE ENGINEER
Salem, Oregon

JACK Well Record
35059

STATE WELL NO. 38/1W-14E
COUNTY Jackson
APPLICATION NO. GR-1269

GR- 1225

OWNER: Maynard M. Stutzman


MAILING ADDRESS: Rt. 1, Box 286

LOCATION OF WELL: Owner's No.

CITY AND STATE: Talent, Oregon

SE 1/4 SW 1/4 Sec. 14 T. 38 S., R. 1 W., W.M.

Bearing and distance from section or subdivision corner 1000' N. & 500' E. from SW cor. DIC #80.

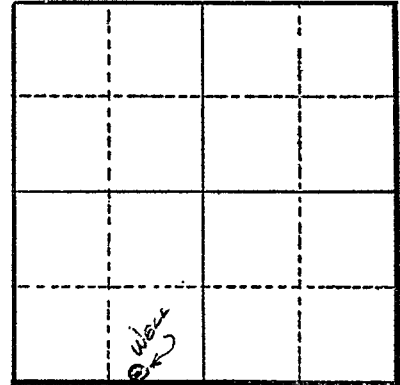

Altitude at well

TYPE OF WELL: Dug Date Constructed 1942

Depth drilled Sump 18 ft. Depth cased

Section 14

CASING RECORD:

Infiltration trench - 40 x 20 x 18 ft.

FINISH:

AQUIFERS:

WATER LEVEL:

PUMPING EQUIPMENT: Type Portland Pump Co. H.P. 20
Capacity 240± G.P.M.

WELL TESTS:

Drawdown ft. after hours G.P.M.
Drawdown ft. after hours G.P.M.

USE OF WATER Irrigation Temp. °F., 19

SOURCE OF INFORMATION G.R. Record

DRILLER or DIGGER

ADDITIONAL DATA:

Log N.A. Water Level Measurements Chemical Analysis Aquifer Test

REMARKS:

Irrigation of 12.7 acres.